



AMENDMENTS :

AMENDMENT	DATE	DESCRIPTION
R1	22.10.25	No change this sheet
R2	23.10.25	No change this sheet

NOTES :

1.

This plan has been prepared for sewer asbuilt purposes only. No liability is accepted if the plan is used for any other purpose.

2.

Any measurements taken from information which is not dimensioned on the electronic copy are at the risk of the recipient.

3.

All sewer laterals are 100mmØ uPVC SN16 unless shown otherwise specified.

4.

All roading and footpath information is asbuilt.

5.

Origin of Levels;  
SP 1 SO 462877 (EMDF)  
RL=15.943m

Levels are in terms of New Zealand Vertical Datum 2016.

LEGEND

LL= LID LEVEL

IL= INVERT LEVEL

SANITARY SEWER

EXISTING SANITARY SEWER

ASBUILT KERB AND CHANNEL

ASBUILT FOOTPATH

MH

SEWER LATERAL

EX.MH

EX.SEWER LATERAL

CUTDOWN

DAVIE LOVELL-SMITH

PLANNING SURVEYING ENGINEERING

116 Wrights Road

P O Box 679 Christchurch 8140. New Zealand

Telephone: 03 379-0793 Website: www.dls.co.nz E-mail: office@dls.co.nz

JOB TITLE:

The Hamptons  
Stage 4A & 5  
RC 235448

SHEET TITLE:

Sewer Asbuilt

DRAWING STATUS

Asbuilt

SCALE : 1:500@A1  
1:1000@A3

DATE : October 2025

CAD FILE : J:\20864\ASBUILT\STAGE 4\E.20864\_STAGE 4\_AB\_NZTM\_NZVD16\_R2.dwg


DRAWN : SC

DRAWING No : SHEET No :

REVISION :

E.20864.AB.SS01

R2

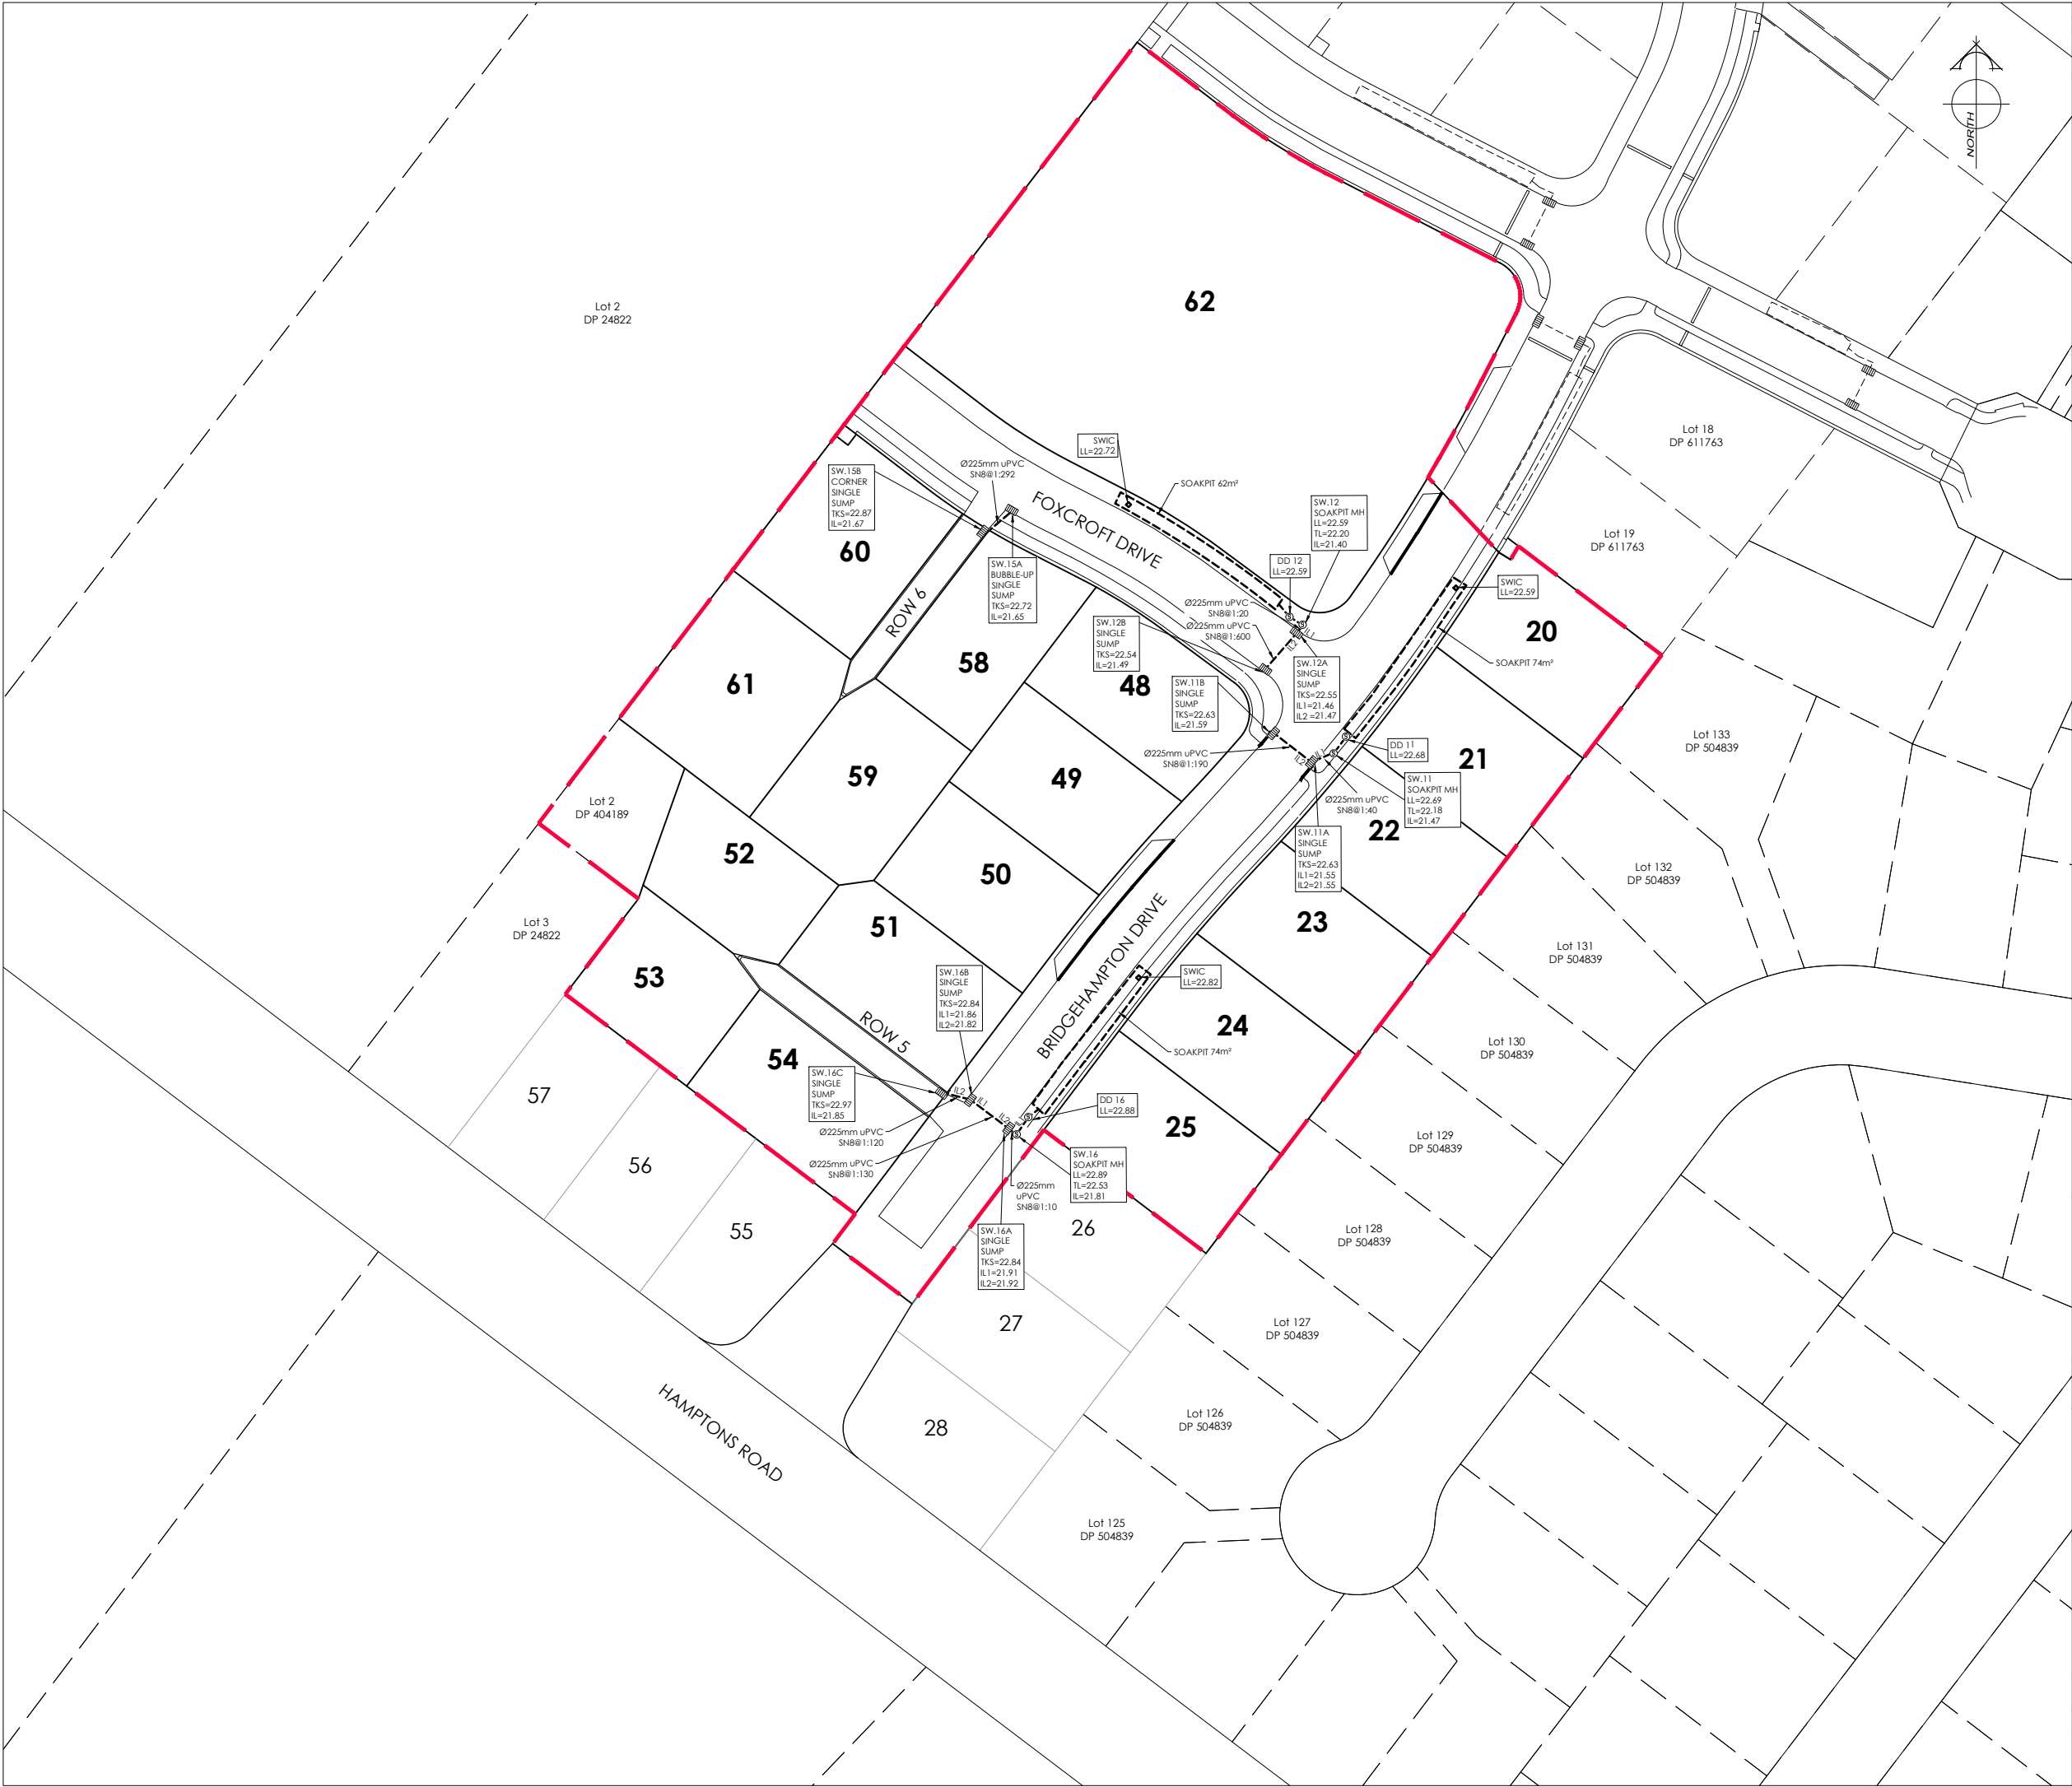

AMENDMENTS :

AMENDMENT	DATE	DESCRIPTION
R1	22.10.25	No change this sheet
R2	23.10.25	No change this sheet

NOTES :

1.

This plan has been prepared for stormwater asbuilt purposes only. No liability is accepted if the plan is used for any other purpose.

2.

Any measurements taken from information which is not dimensioned on the electronic copy are at the risk of the recipient.

3.

All roading and footpath information is asbuilt.

4.

All stormwater pipes are Ø225 uPVC unless stated otherwise

5.

Origin of Levels:  
SP 1 SO 462877 (EMDF)  
RL=15.943m

Levels are in terms of New Zealand Vertical Datum 2016.

LEGEND

LL=

LID LEVEL

IL=

INVERT LEVEL

TKS=

TOP OF KERB AT SUMP

TL=

TIP LEVEL

SWIC=

STORMWATER INSPECTION CHAMBER

DD=

DOWNSTREAM DEFENDER

STORMWATER

MH

---

---

EXISTING STORMWATER

EX.MH

---

---

ASBUILT KERB AND CHANNEL

SUMP

DOUBLE SUMP

CUTDOWN

ASBUILT FOOTPATH

=====

DAVIE LOVELL-SMITH

PLANNING SURVEYING ENGINEERING

116 Wrights Road

P O Box 679 Christchurch 8140. New Zealand

Telephone: 03 379-0793 Website: www.dls.co.nz E-mail: office@dls.co.nz

JOB TITLE:

The Hamptons  
Stage 4A & 5  
RC 235448

SHEET TITLE:

Stormwater Asbuilt

DRAWING STATUS

Asbuilt

SCALE: 1:500@A1  
1:1000@A3

DATE: October 2025

CAD FILE : J:\20864\ASBUILT\STAGE 4\E.20864\_STAGE 4\_AB\_NZTM\_NZVD16\_R2.dwg




DRAWN : SC

DRAWING No : SHEET No:

REVISION :

E.20864.AB.SW01

R2

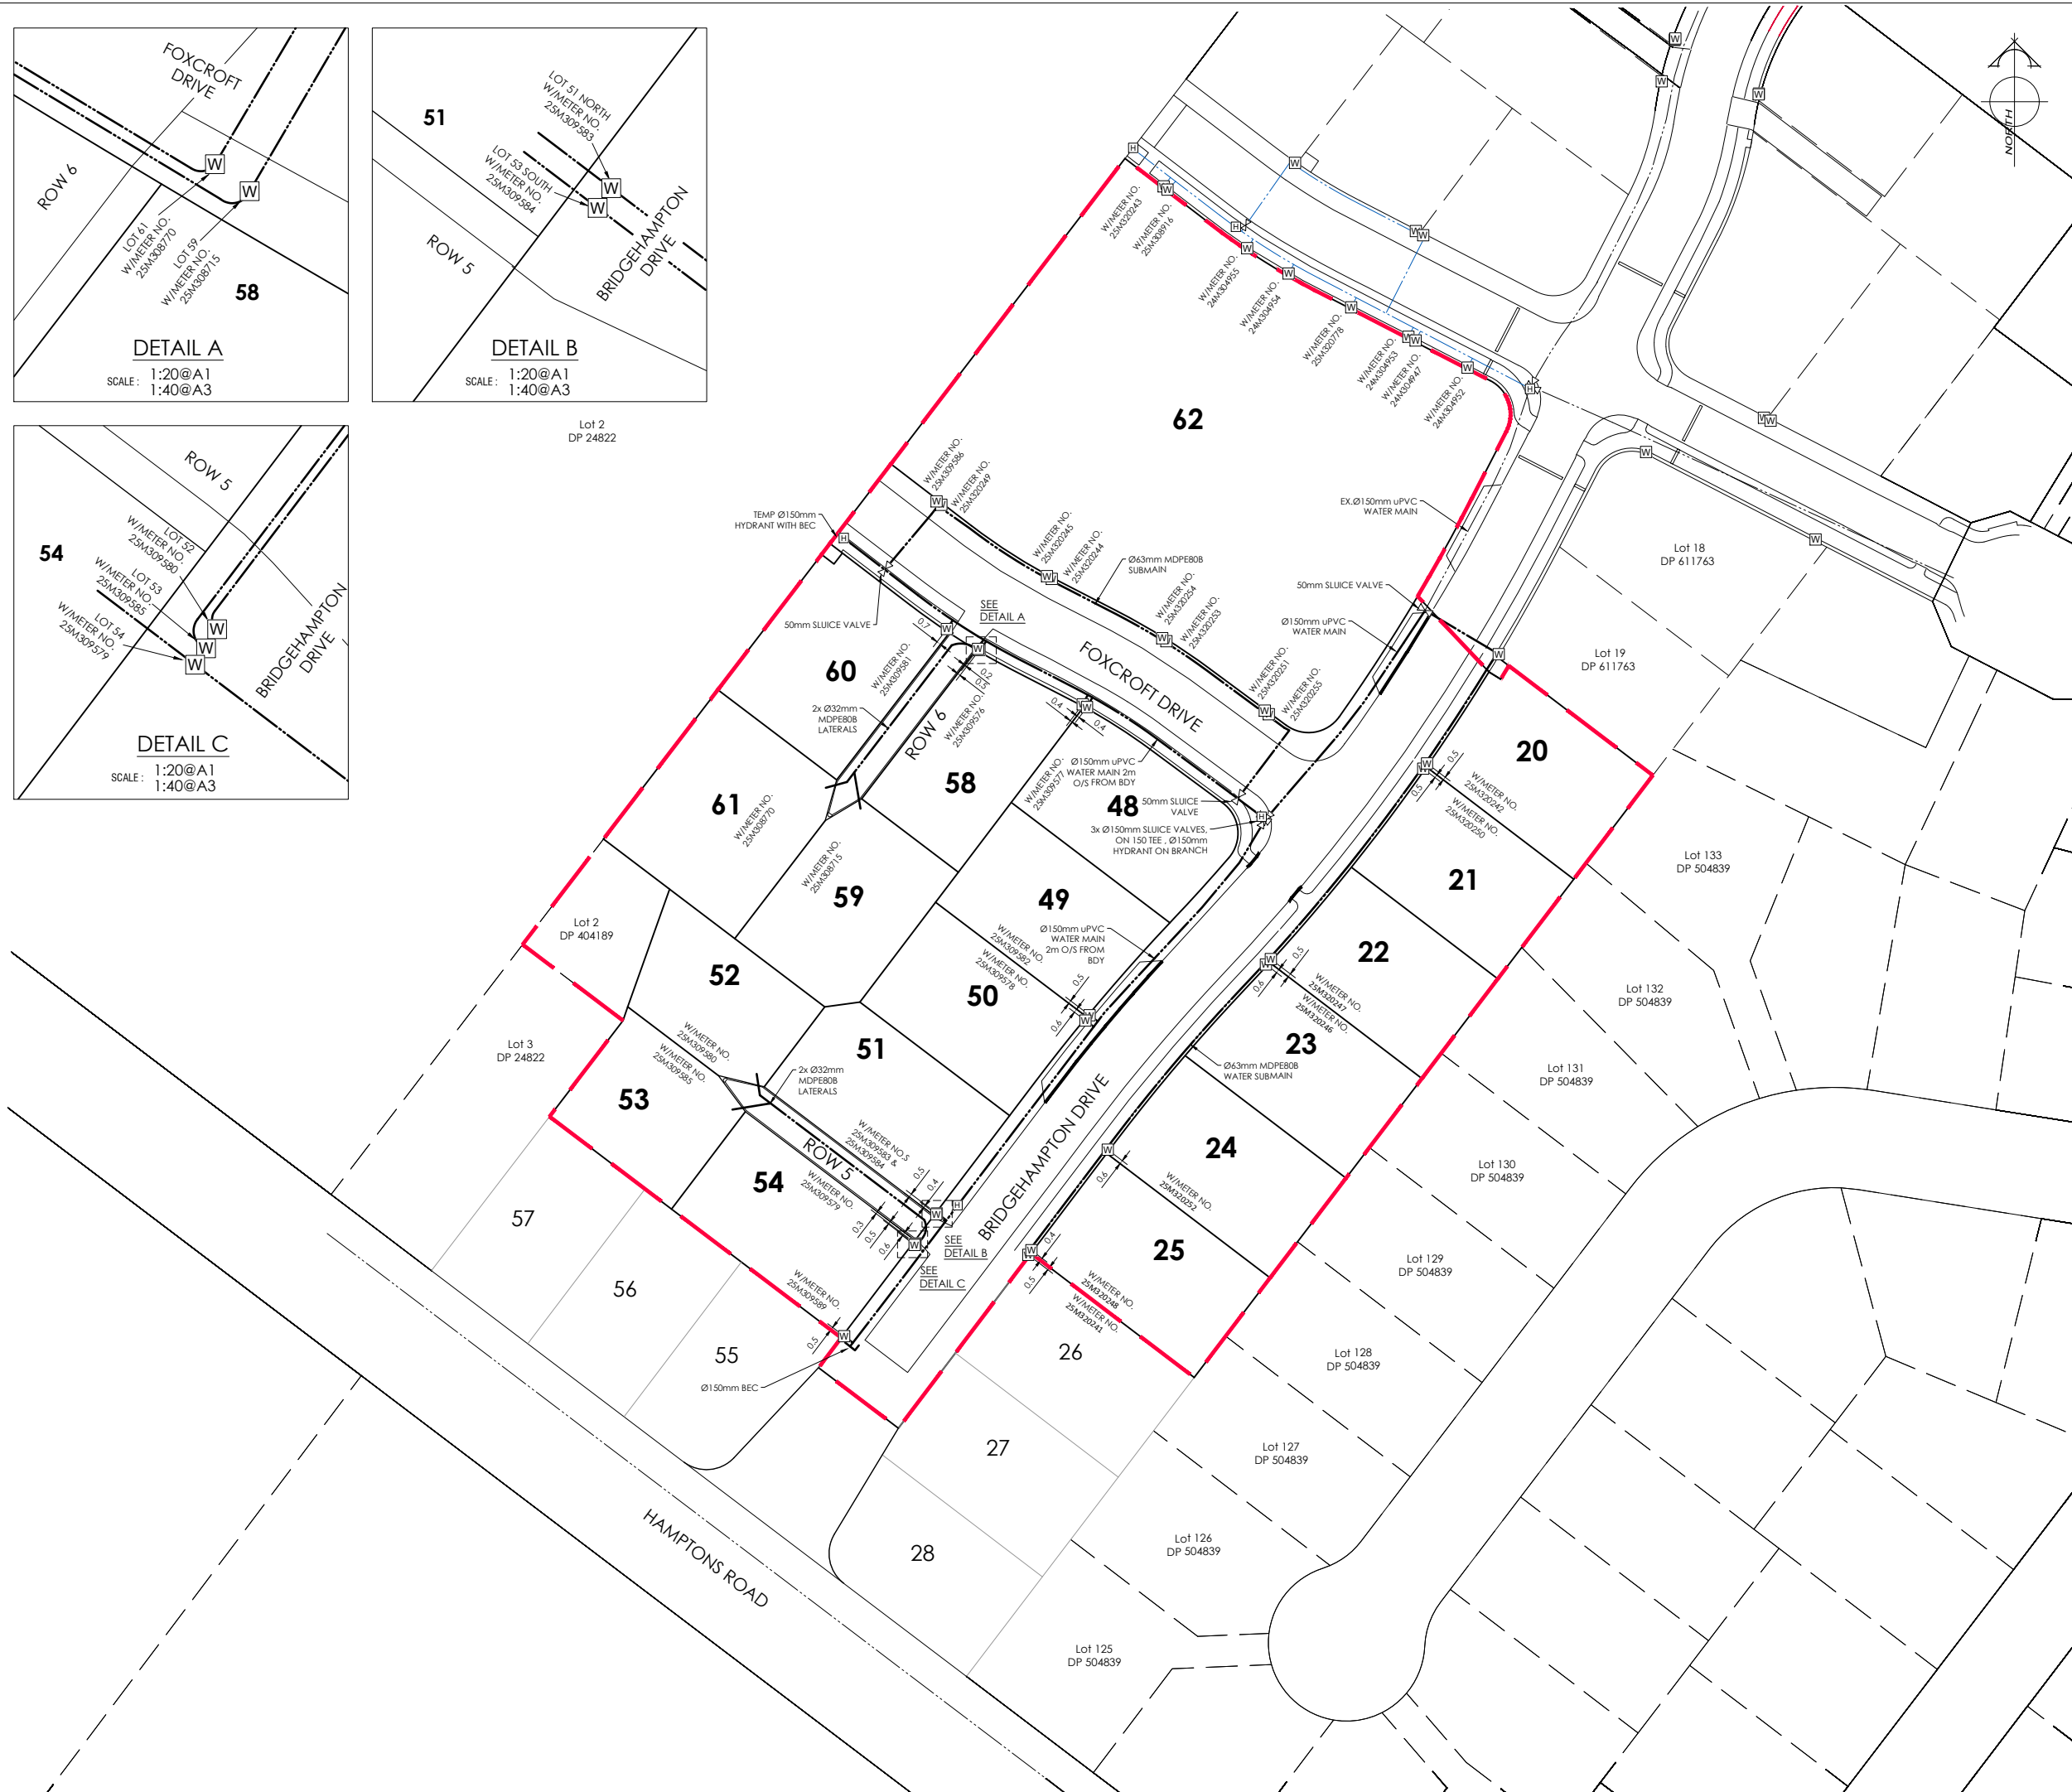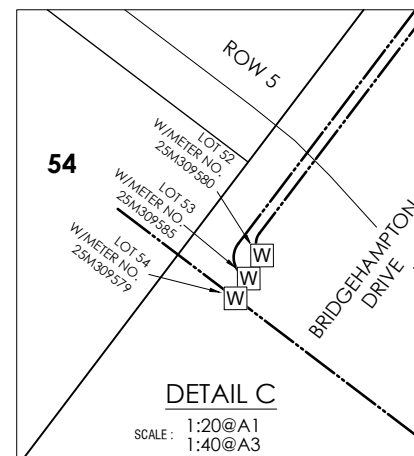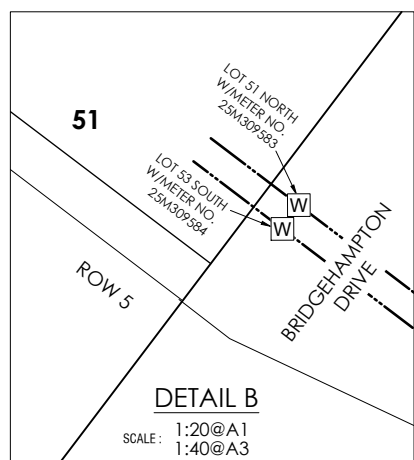

AMENDMENTS :		
AMENDMENT	DATE	DESCRIPTION
R1	22.10.25	Water asbuilts updated
R2	23.10.25	Water meter details added

NOTES :

1. This plan has been prepared for water asbuilt purposes only. No liability is accepted if the plan is used for any other purpose.
2. Any measurements taken from information which is not dimensioned on the electronic copy are at the risk of the recipient.
3. All house connections are 25mm poly and include gate valve , toby box, tapping band and ferrule.
4. All water laterals are Ø25mm PE BlueLine PN12.5 with associated fittings unless otherwise specified.
5. All roading and footpath information is asbuilt.

## LEGEND

The diagram illustrates the layout of a water supply system. It consists of several horizontal lines representing different components:

- WATER:** A solid line with a valve symbol (two triangles pointing towards each other) and a connection symbol (a square with a 'W' inside). Labels 'FH' and 'VALVE' are above the valve, and 'W' and 'CONNECTION' are above the connection symbol.
- EXISTING WATER:** A dashed line with a valve symbol and a connection symbol. Labels 'H' and 'W' are above the connection symbol.
- ASBUILT KERB AND CHANNEL:** A solid line with a thick black rectangle labeled 'CUTDOWN'.
- ASBUILT FOOTPATH:** A solid line.



116 Wrights Road P O Box 679 Christchurch 8140. New Zealand  
Telephone: 03 379-0793 Website: [www.dls.co.nz](http://www.dls.co.nz) E-mail: [office@dls.co.nz](mailto:office@dls.co.nz)

JOB TITLE:

**The Hamptons  
Stage 4A & 5  
RC 235448**

SHEET TITLE:

## Water Asbuilt

DRAWING STATUS	
----------------	--

## Asbuilt

SCALE :	1:500@A1 1:1000@A3
---------	-----------------------

DATE: October 2025

CAD FILE : J:\20864\ASBUILT\STAGE 4\E.20864\_STAGE 4\_AB\_NZTM\_NZVD16\_R2.dwg

DRAWING No


SHEET No:

**E.20864.AB.WS01**

DRAWN : SC


**R2**



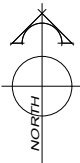


AMENDMENTS :		
AMENDMENT	DATE	DESCRIPTION
R1	22.10.25	No change this sheet
R2	23.10.25	No change this sheet

- NOTES :
1. This plan has been prepared for road asbuilt purposes only. No liability is accepted if the plan is used for any other purpose.
  2. Any measurements taken from information which is not dimensioned on the electronic copy are at the risk of the recipient.
  3. Carriageway dimensions shown are from face of kerb to face of kerb.

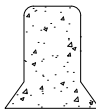

KERB ONLY TO CCC SD602

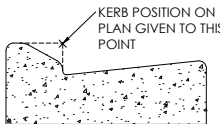

MOUNTABLE KERB & CHANNEL

LEGEND

COBBLE STONES	
EXPOSED AGGREGATE CONCRETE	
DG10	
ASBUILT KERB AND CHANNEL	
ASBUILT FOOTPATH	
CUTDOWN	



116 Wrights Road P O Box 679 Christchurch 8140. New Zealand  
Telephone: 03 379-0793 Website: www.dls.co.nz E-mail: office@dls.co.nz



JOB TITLE:  
**The Hamptons  
Stage 4A & 5  
RC 235448**

SHEET TITLE:  
**Roading Asbuilt**

DRAWING STATUS  
**Asbuilt**


SCALE : 1:500@A1  
1:1000@A3  
DATE : October 2025

CAD FILE : J:\20864\ASBUILT\STAGE 4\E.20864_STAGE 4_AB_NZTM_NZVD16_R2.dwg	DRAWN : SC
DRAWING No : <b>E.20864.AB.RD01</b>	REVISION : <b>R2</b>

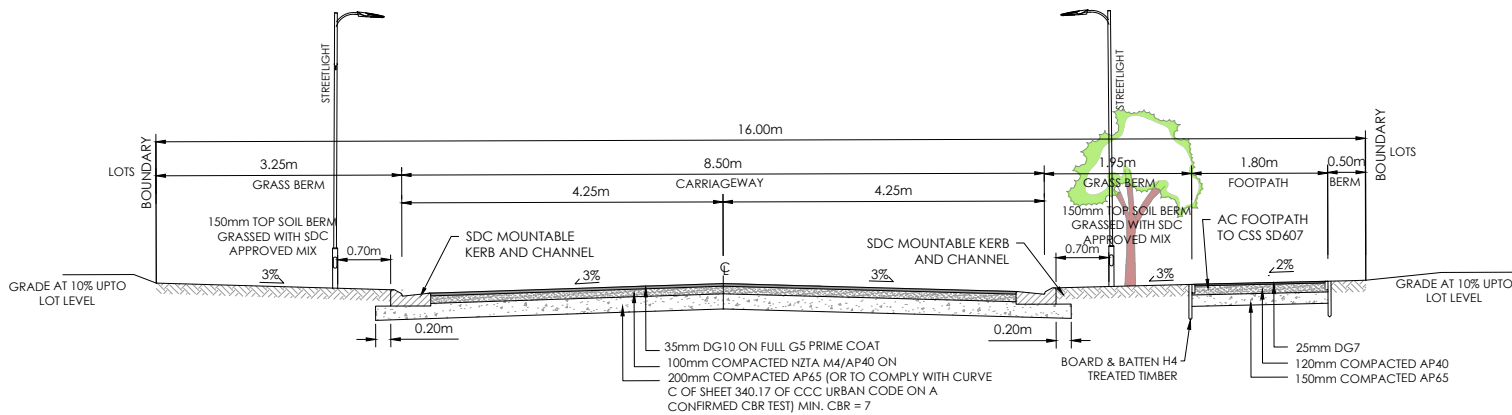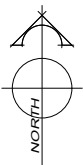


TYPICAL CROSS SECTION 16m BRIDGEHAMPTON DRIVE & FOXCROFT DRIVE

SCALE 1:50@A1  
1:100@A3

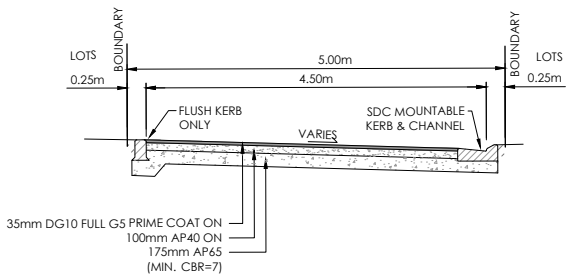


TYPICAL CROSS SECTION ROW 5 & 6

SCALE 1:50@A1  
1:100@A3

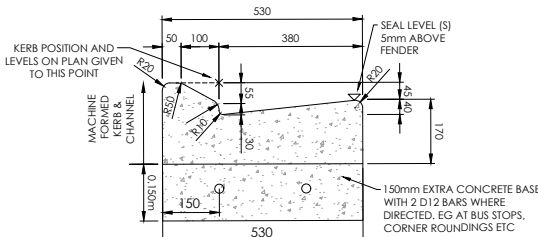

SDC MOUNTABLE KERB & CHANNEL

SCALE 1:10@A1  
1:20@A3

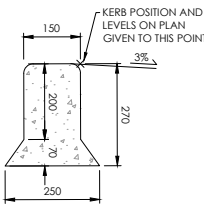

KERB ONLY TO CCC SD602

SCALES 1:10@A1  
1:20@A3

AMENDMENTS :		
AMENDMENT	DATE	DESCRIPTION
R1	22.10.25	No change this sheet
R2	23.10.25	No change this sheet



116 Wrights Road P O Box 679 Christchurch 8140. New Zealand  
Telephone: 03 379-0793 Website: www.dls.co.nz E-mail: office@dls.co.nz

JOB TITLE:

**The Hamptons  
Stage 4A & 5  
RC 235448**

SHEET TITLE:

**Roading Cross Sections**

DRAWING STATUS

**Asbuilt**

SCALE: As Shown

DATE: October 2025

CAD FILE : J:\20864\ASBUILT\STAGE 4\E.20864\_STAGE 4\_AB\_NZTM\_NZVD16\_R2.dwg DRAWN : SC

DRAWING No :

SHEET No:

**E.20864.AB.RD02**

REVISION :

**R2**