
AS-BUILT PLAN SEWER



AS-BUILT PLAN ROADING


Ш



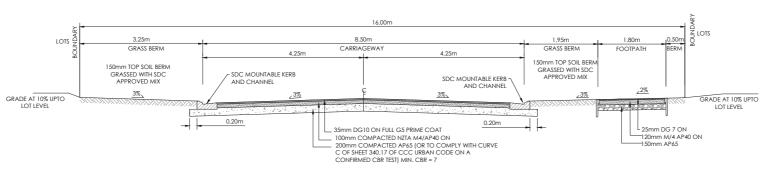


TYPICAL CROSS SECTION 16m ROAD 1 & 3

SCALE 1:50@A1 1:100@A3

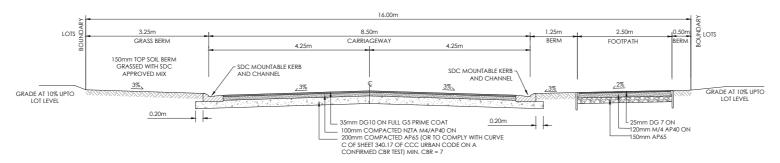


TYPICAL CROSS SECTION 16m ROAD 2

SCALE 1:50@A1 1:100@A3

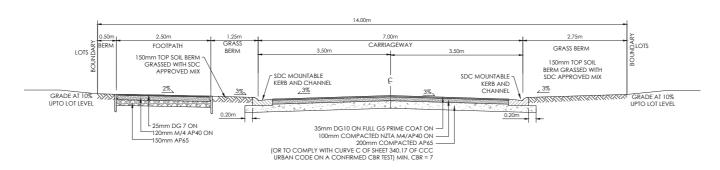

TYPICAL CROSS SECTION - GUINEA DRIVE

SCALE 1:50@A1 1:100@A3

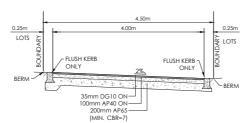

TYPICAL CROSS SECTION ACCESS SCALES 1:50@A1

:S 1:50@A1 1:100@A3