


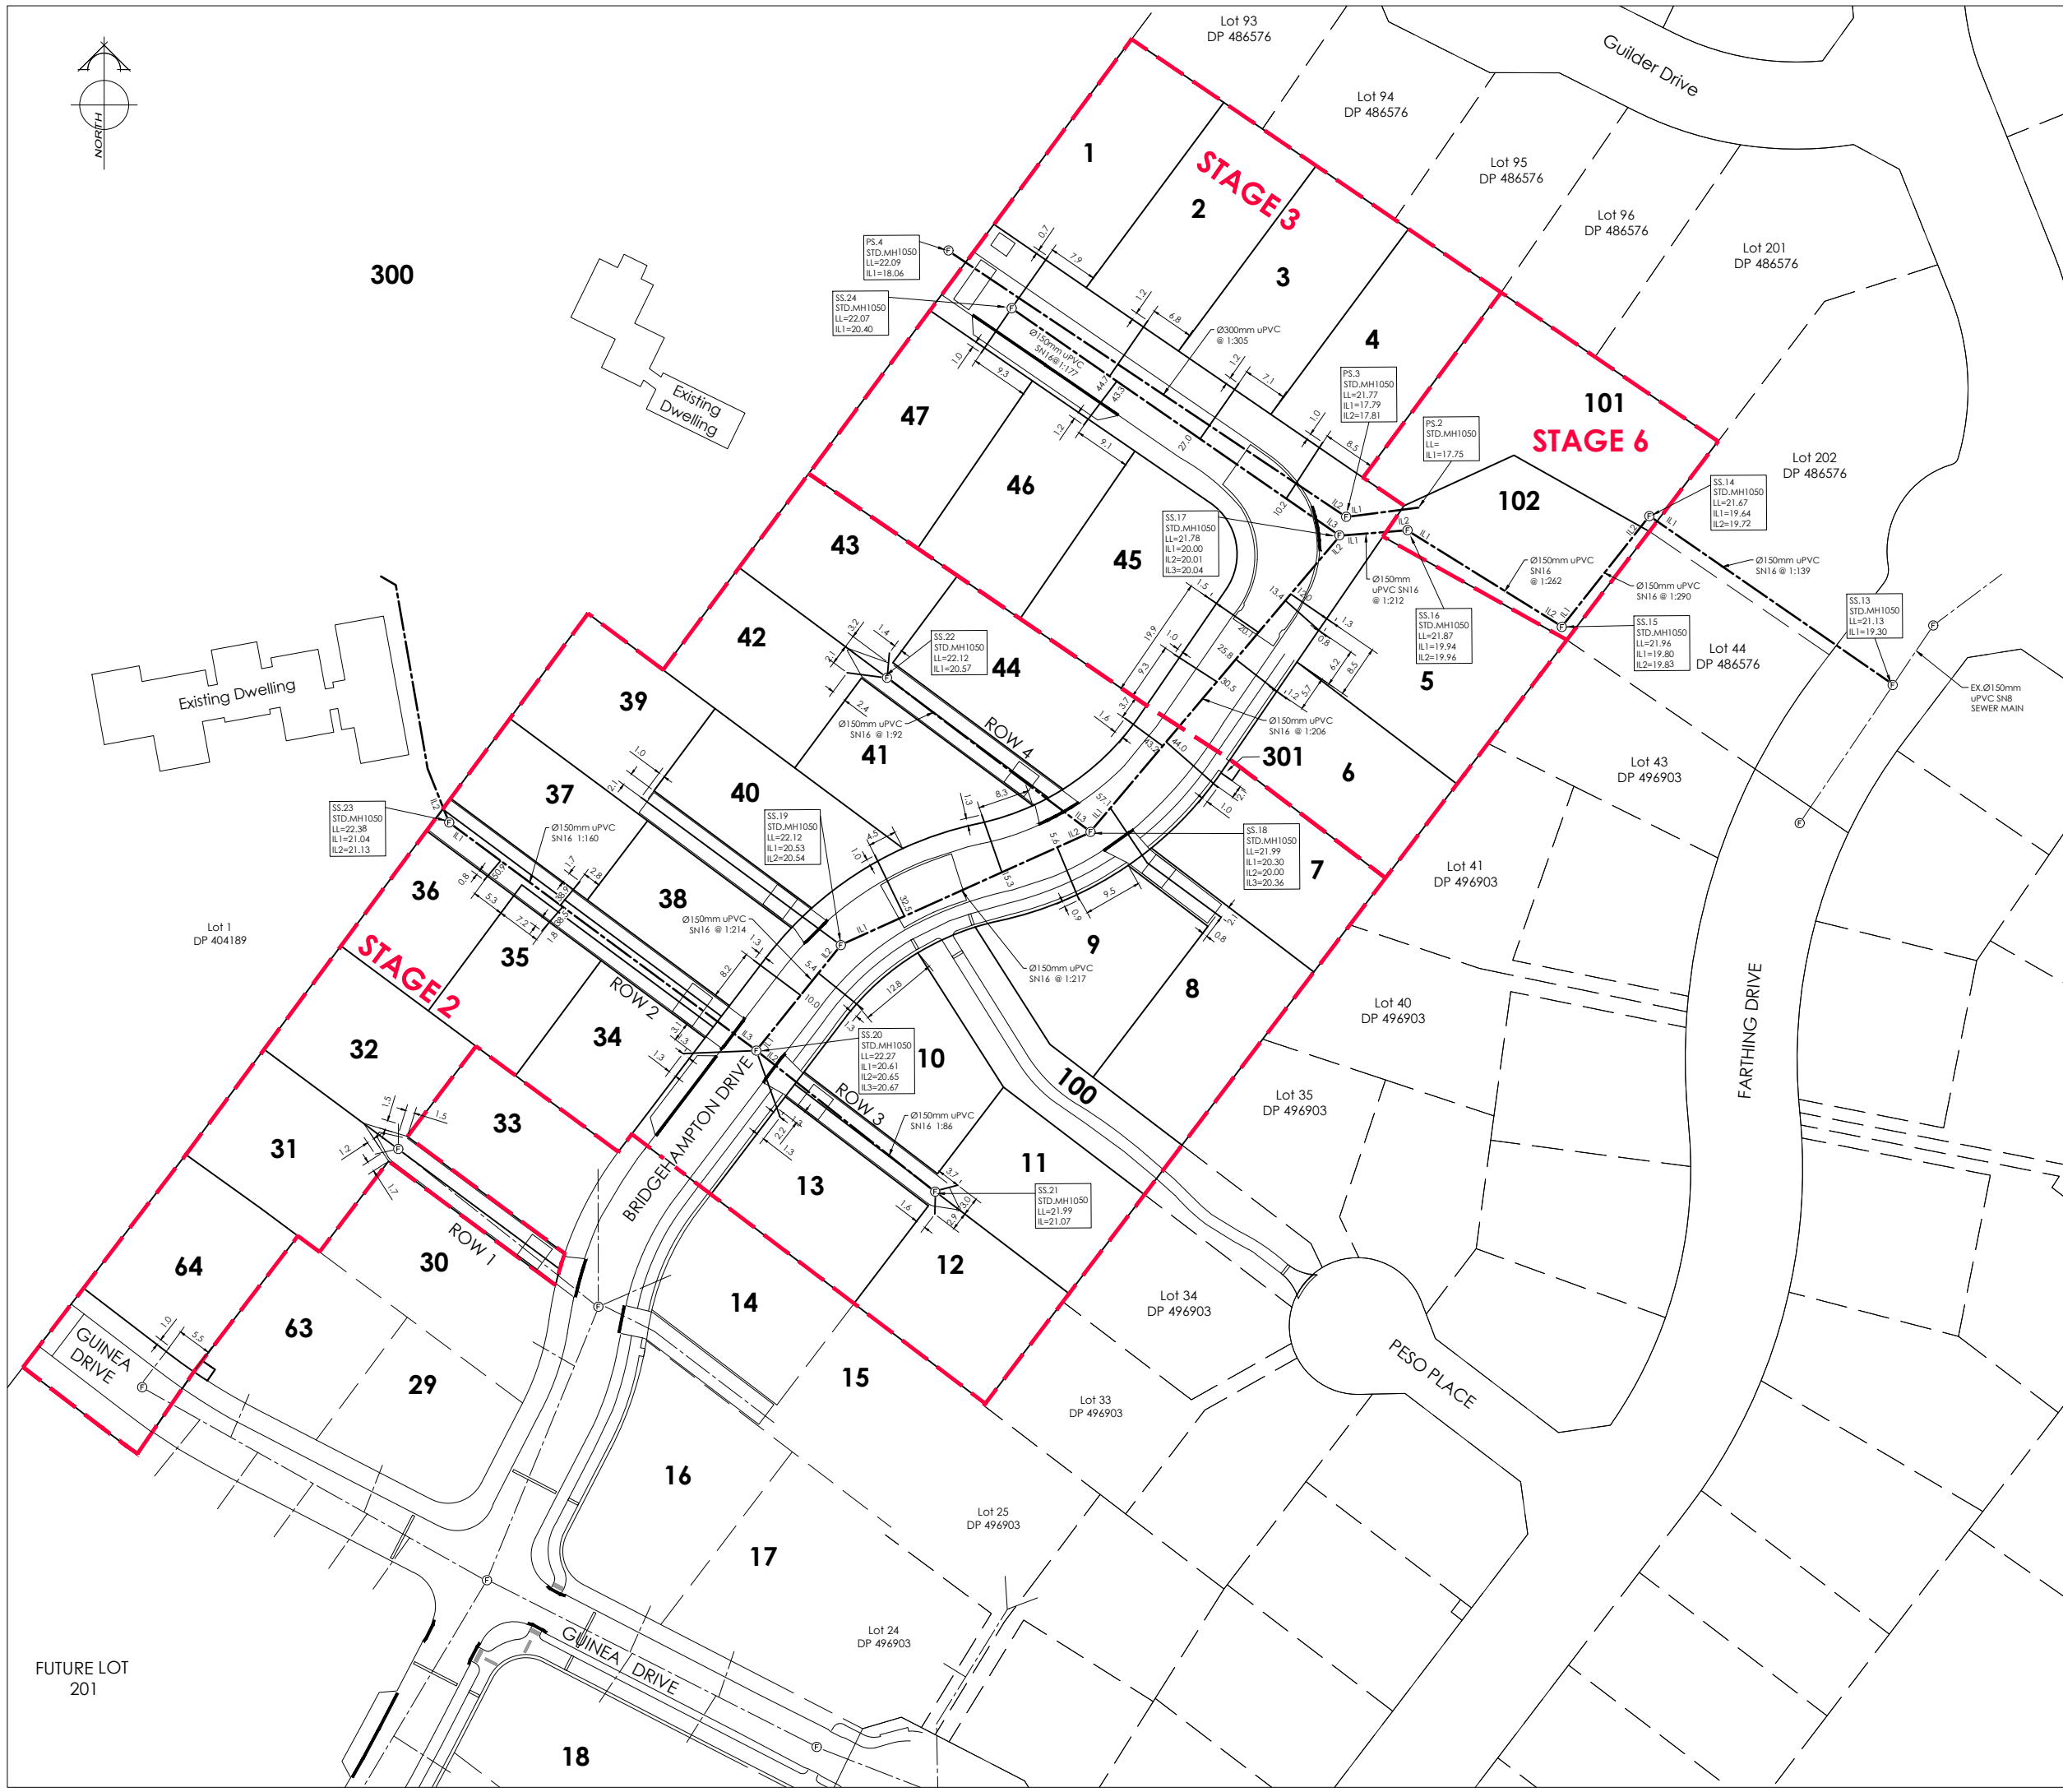

AMENDMENTS:

AMENDMENT	DATE	DESCRIPTION

NOTES:

- This plan has been prepared for sewer asbuilt purposes only. No liability is accepted if the plan is used for any other purpose.
- Any measurements taken from information which is not dimensioned on the electronic copy are at the risk of the recipient.
- All sewer laterals are 100mmØ uPVC SN16 unless shown otherwise specified.
- All roading and footpath information is asbuilt.
- Origin of Levels:
SP 1 SO 462877 (EMDF)
RL=15.943m

Levels are in terms of New Zealand Vertical Datum 2016.

LEGEND

LL= LID LEVEL
IL= INVERT LEVEL

	SEWER LATERAL
SANITARY SEWER	MH
EXISTING SANITARY SEWER	EX.MH

	CUTDOWN
ASBUILT KERB AND CHANNEL	
ASBUILT FOOTPATH	

DAVIE LOVELL-SMITH
PLANNING SURVEYING ENGINEERING

116 Wrights Road P O Box 679 Christchurch 8140. New Zealand
Telephone: 03 379-0793 Website: www.dls.co.nz E-mail: office@dls.co.nz

JOB TITLE:

**The Hamptons
Stages 2 & 3**

SHEET TITLE:

Sewer Asbuilt

DRAWING STATUS:


Asbuilt

SCALE: 1:500@A1
1:1000@A3 DATE: April 2025

CAD FILE: J:\20864\ASBUILT\STAGE 2 & 3\1.E.20864.STG 2 & 3 AB_NZM_NEVD_R0.dwg DRAWN: SC

DRAWING No: SHEET No: REVISION:

E.20864.AB.SS01 **R0**

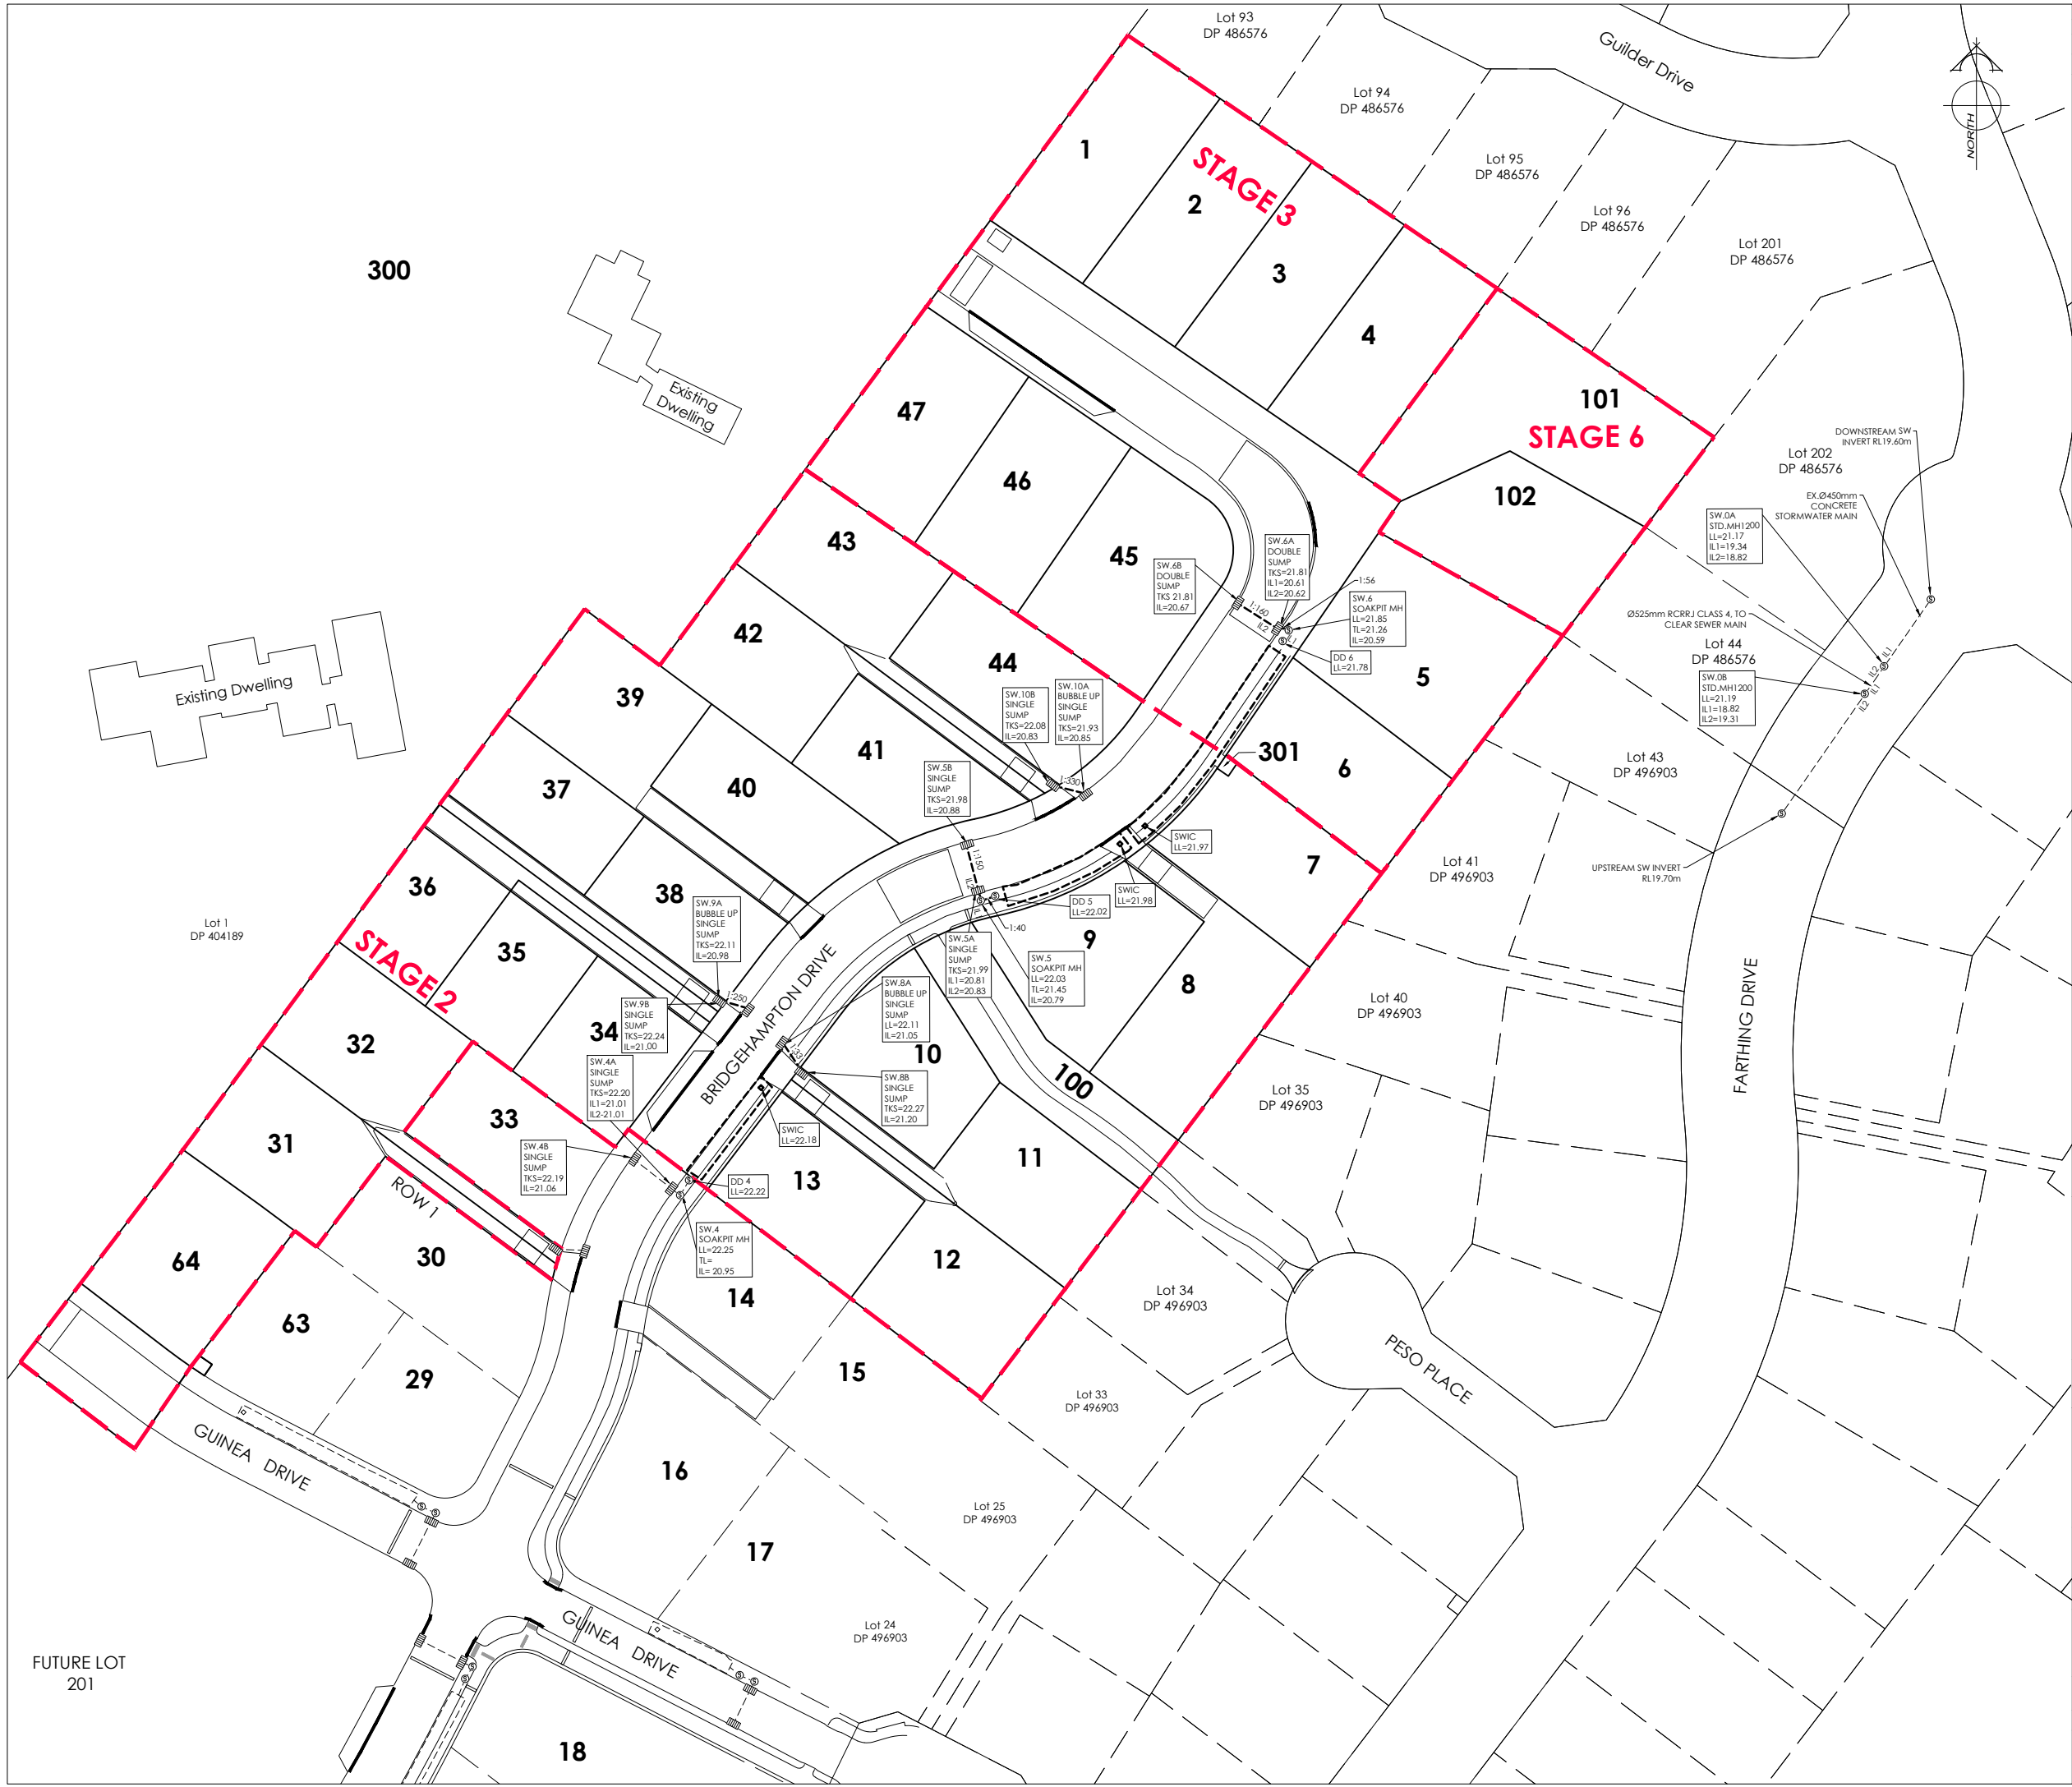

AMENDMENTS :

AMENDMENT	DATE	DESCRIPTION

NOTES :

1. This plan has been prepared for stormwater asbuilt purposes only. No liability is accepted if the plan is used for any other purpose.

2. Any measurements taken from information which is not dimensioned on the electronic copy are at the risk of the recipient.

3. All roading and footpath information is asbuilt.

4. All stormwater pipes are Ø225 uPVC unless stated otherwise

5. **Origin of Levels:**
SP 1 SO 462877 (EMDF)
RL=15.943m

Levels are in terms of New Zealand Vertical Datum 2016.

LEGEND

LL= LID LEVEL

IL= INVERT LEVEL

TKS= TOP OF KERB AT SUMP

TL= TIP LEVEL

SWIC= STORMWATER INSPECTION CHAMBER

DD= DOWNSTREAM DEFENDER

STORMWATER

EXISTING STORMWATER

ASBUILT KERB AND CHANNEL

ASBUILT FOOTPATH

MH

EX.MH

SUMP

DOUBLE SUMP

CUTDOWN

DAVIE LOVELL-SMITH

PLANNING SURVEYING ENGINEERING

116 Wrights Road

P O Box 679 Christchurch 8140. New Zealand

Telephone: 03 379-0793 Website: www.dls.co.nz E-mail: office@dls.co.nz

JOB TITLE:

The Hamptons
Stages 2 & 3

SHEET TITLE:

Stormwater Asbuilt

DRAWING STATUS

Asbuilt

SCALE: 1:500@A1
1:1000@A3


DATE: April 2025

CAD FILE : J:\20864\ASBUILT\STAGE 2 & 3\1.E.20864_STG 2 & 3_AB_NZTM_NEVD_R0.dwg

DRAWN : SC

DRAWING No :
E.20864.AB.SW01

SHEET No :
R0

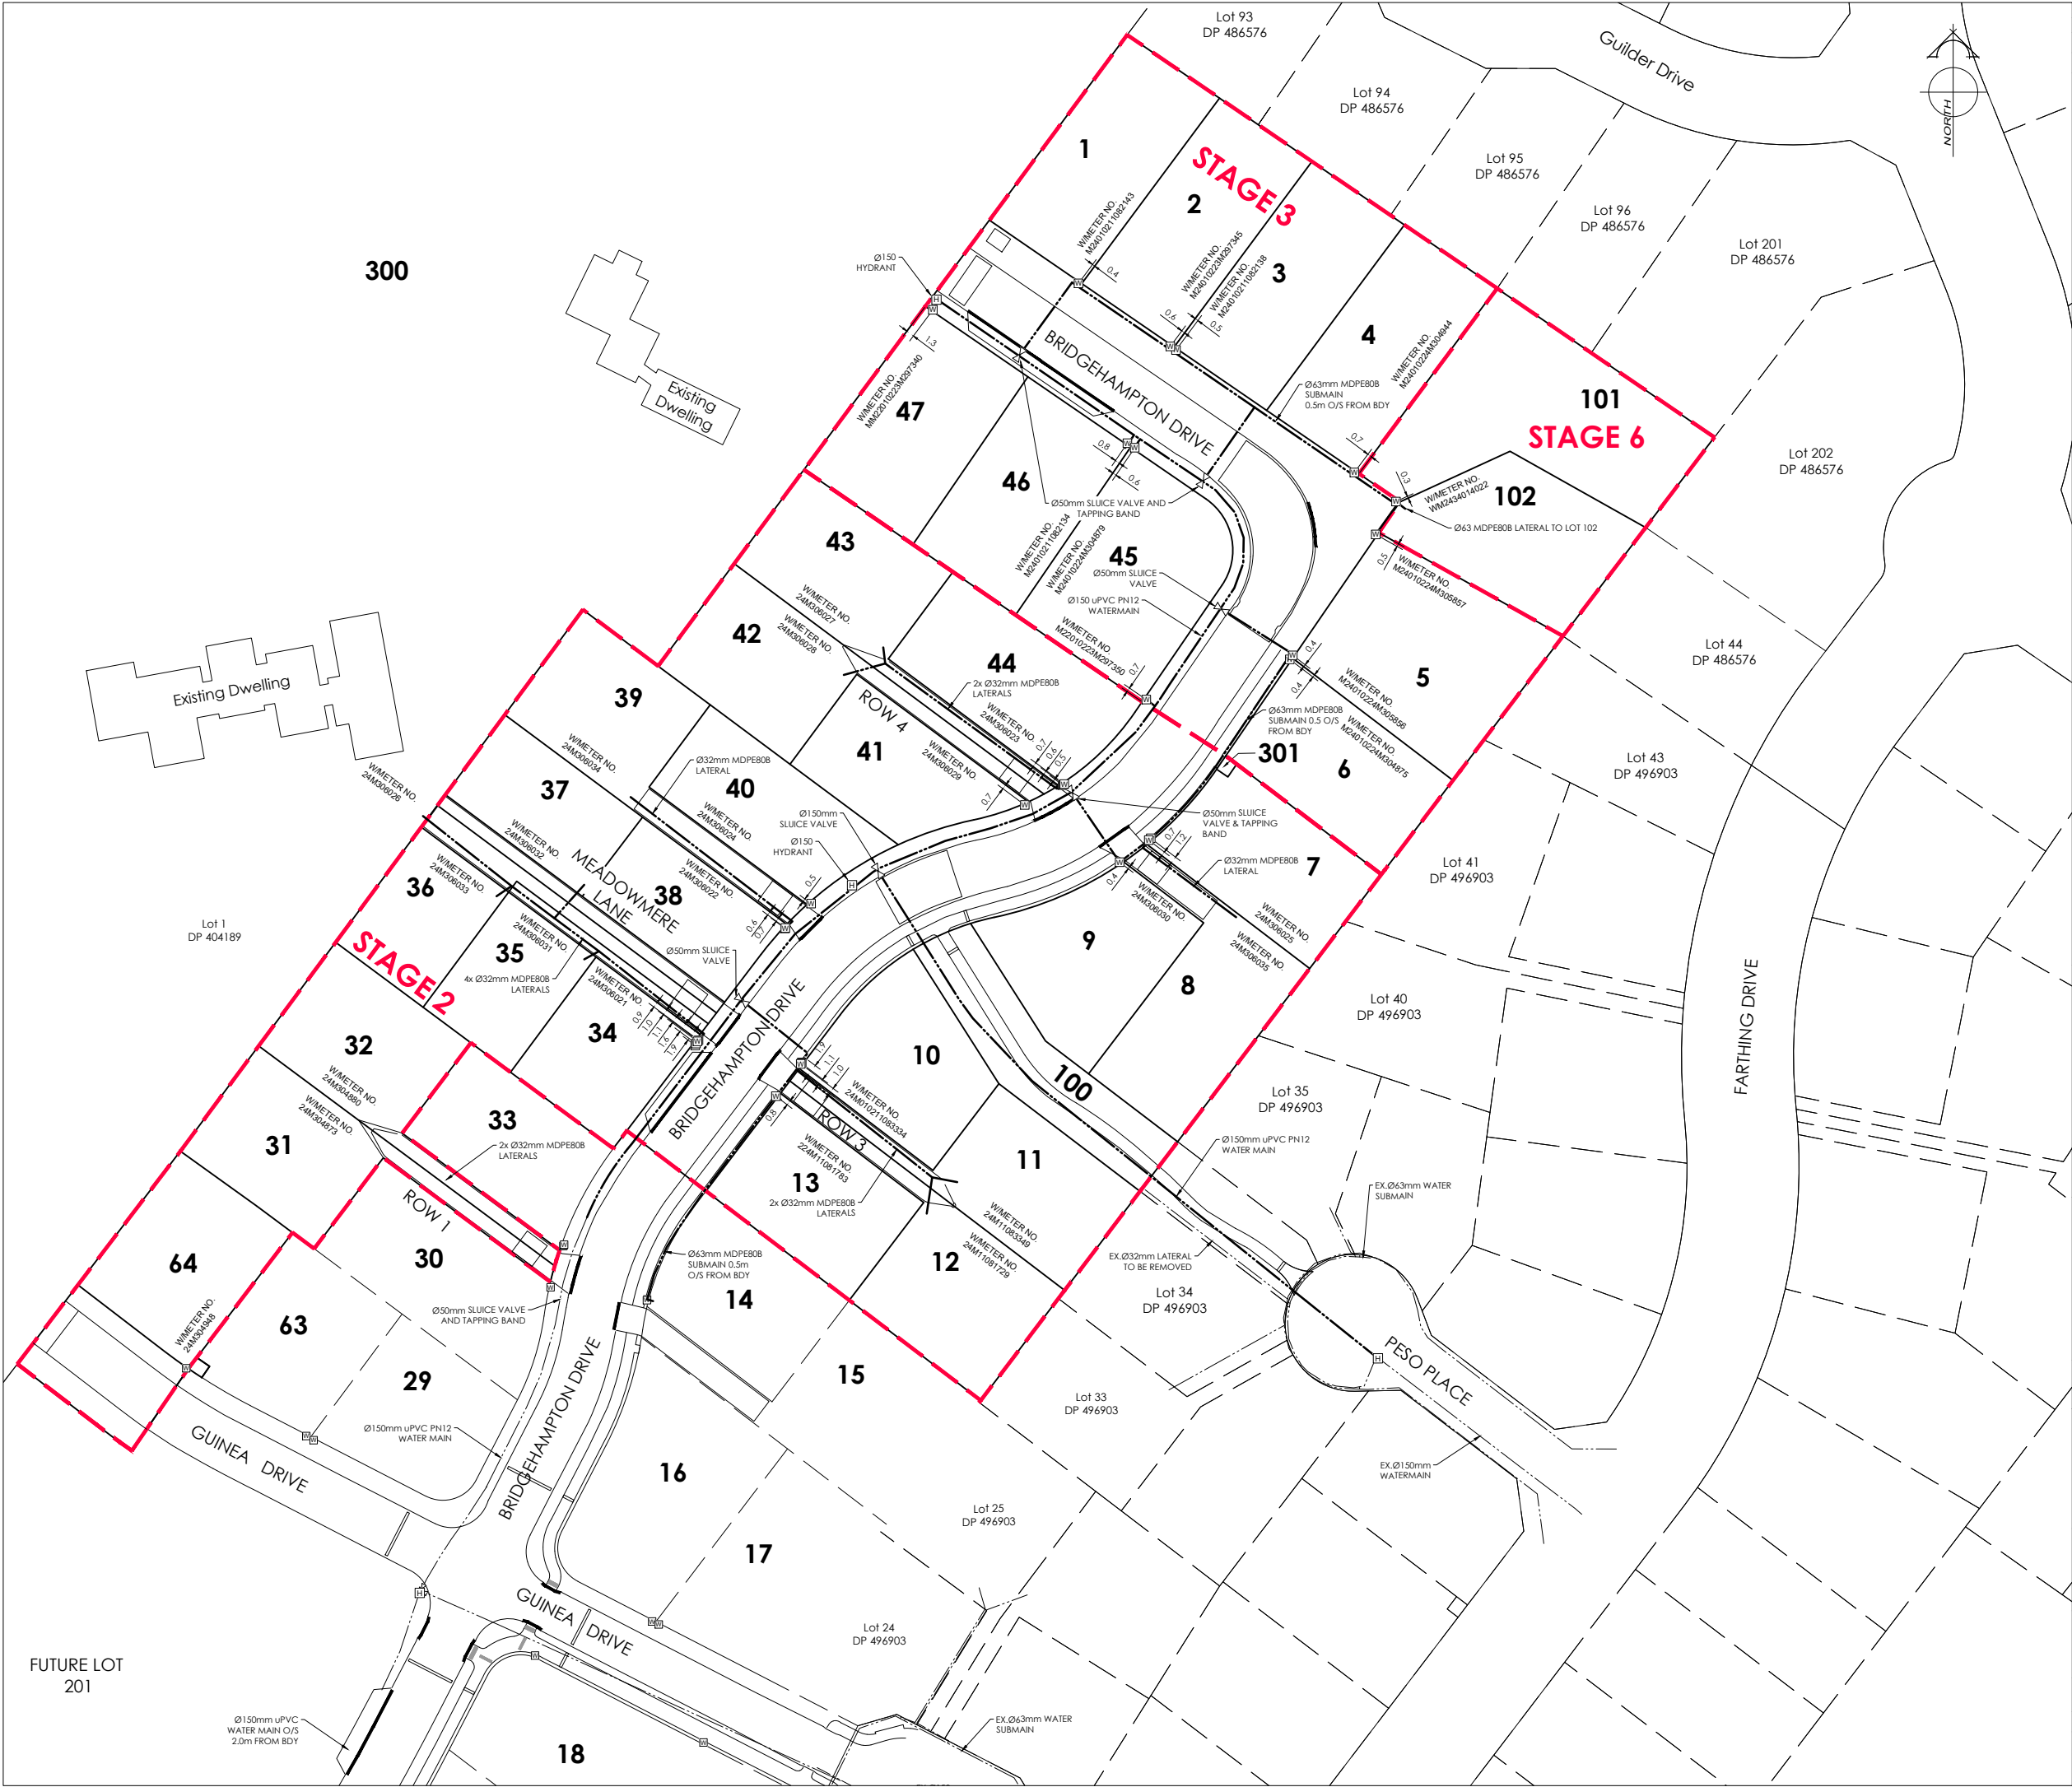

AMENDMENTS :		
AMENDMENT	DATE	DESCRIPTION
NOTES :		
1. This plan has been prepared for water asbuilt purposes only. No liability is accepted if the plan is used for any other purpose.		
2. Any measurements taken from information which is not dimensioned on the electronic copy are at the risk of the recipient.		
3. All house connections are 25mm poly and include gate valve , toby box, tapping band and ferrule.		
4. All water laterals are Ø25mm PE BlueLine PN12.5 with associated fittings unless otherwise specified.		
5. All roading and footpath information is asbuilt.		
6. Origin of Levels: SP 1 SO 462877 (EMDF) RL=15.943m		
Levels are in terms of New Zealand Vertical Datum 2016.		



AMENDMENTS :

AMENDMENT	DATE	DESCRIPTION

NOTES :

1.

This plan has been prepared for road asbuilt purposes only. No liability is accepted if the plan is used for any other purpose.

2.

Any measurements taken from information which is not dimensioned on the electronic copy are at the risk of the recipient.

3.

Carriageway dimensions shown are from face of kerb to face of kerb.

4.

Origin of Levels:
SP 1 SO 462877 (EMDF)
RL=15.943m

Levels are in terms of New Zealand Vertical Datum 2016.

KERB ONLY TO CCC SD602

MOUNTABLE KERB & CHANNEL

SDC MOUNTABLE KERB & CHANNEL WITH SD6111 REINFORCING

LEGEND

DG10

COBBLES

EXPOSED AGGREGATE

ASBUILT KERB AND CHANNEL

ASBUILT FOOTPATH

CUTDOWN

DAVIE LOVELL-SMITH

PLANNING SURVEYING ENGINEERING

116 Wrights Road P O Box 679 Christchurch 8140. New Zealand
Telephone: 03 379-0793 Website: www.dls.co.nz E-mail: office@dls.co.nz

JOB TITLE:

The Hamptons

Stages 2 & 3

SHEET TITLE:

Roading Asbuilt

DRAWING STATUS

Asbuilt

SCALE: 1:500@A1
1:1000@A3

DATE: April 2025

CAD FILE : J:\20864\ASBUILT\STAGE 2 & 3\1.E.20864_STG 2 & 3 AB_NZM_NEVD_RD.dwg

DRAWN : SC

DRAWING No : SHEET No:

E.20864.AB.RD01

REVISION :

RO